

Legend  
= Excavation Required for Fire Lane Widening

INSTALL TRAFFIC RATED FIRE SPRINKLER AND IRRIGATION BOX COVERS. REMOVE (E) TREES AS REQ. REGRADE AS REQ.

RELOCATE (E) LIGHT

GENERATOR & ENCLOSURE

RELOCATE (E) LIGHT

FIRE LANE

EXIT

ENTRY

NEW FIRE HYDRANT - SCD

EXIT

INTERNATIONAL HALL

RELOCATE (E) LIGHT

FIRE LANE, SEE G0.05 & G0.09 ADDITIONAL INFO

SCOPE OF WORK

ENTRY

LINE OF ROOF OVERHEAD

ENTRY

FIRE LANE

SALAZAR HALL

DARWIN HALL

SITE PLAN GENERAL NOTES:

1. SEE A 2.1X SERIES FOR ADDITIONAL INFORMATION
2. SEE CIVIL PLANS FOR ADDITIONAL INFORMATION
3. SEE LANDSCAPE PLANS FOR ADDITIONAL INFORMATION
4. SEE G0.05 & G0.09 FOR ADDITIONAL FIRE LANE INFORMATION

SITE PLAN LEGEND:

- FIRE LANE. ACTUAL ROAD WIDTH MAY BE WIDER THAN FIRE LANE WIDTH SHOWN. SCD NOTE: ANY TREE OVERHANG ABOVE THE NOTED FIRE LANE WIDTH WILL BE TRIMMED TO MAINTAIN A MINIMUM OF 15 FOOT CLEAR HEIGHT TO MEET SONOMA COUNTY FIRE SAFETY ORDERS AND OSFM MINIMUM 13.5 FEET REQUIREMENT.
- NEW ASPHALT PAVING - SCD
- NEW CONCRETE PAVING - SCD

Division of the State Architect

Office of the State Fire Marshal

**STEVENSON HALL RENOVATION**  
SONOMA STATE UNIVERSITY  
1801 EAST COTATI AVENUE  
ROHNERT PARK, CA 94928

**TRUEBECK CONSTRUCTION**


**ehdd.**  
ARCHITECTURE  
INTERIORS  
PLANNING URBAN DESIGN

Pier 1 Bay 2  
The Embarcadero  
SAN FRANCISCO  
CALIFORNIA 94111

ARCH@EHDD.COM  
T 415-285-9193

Consultant

Stamp

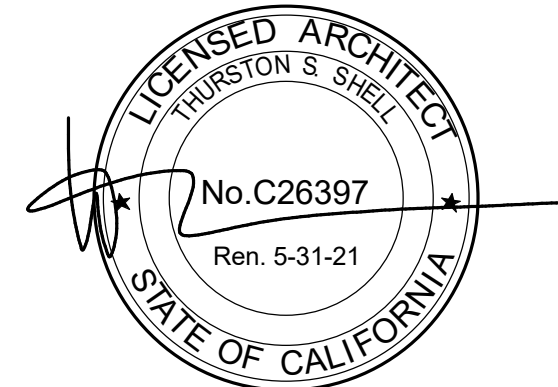

Printing	Date
PERMIT SUBMITTAL - DSA	04.24.2020
95% CONSTRUCTION DOCUMENTS	05.15.2020
PERMIT SET	06.19.2020
PERMIT BACKCHECK #1	07.17.2020
SFM BACKCHECK 1	12.08.2020

Revisions and Description	Date
1 Permit Backcheck #1-R1	08.05.2020
11 OFS Review Comments	12/9/2020
21 RFI 068	04/02/2021
58 RFI 163	09/13/2021
90 Bulletin 32	02/14/2022


EHDD Job Number  
17050

Sheet Title  
**SITE PLAN**

Sheet Number

**A0.11**



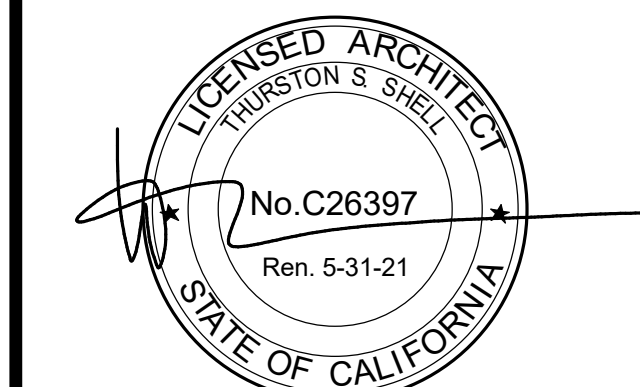

Printing	Date
PERMIT BACKCHECK #1	07.17.2020
SFM BACKCHECK 1	12.09.2020

Revisions and Description	Date
1 Permit Backcheck #1-R1	08.05.2020
58 RFI 163	09/13/2021
90 Bulletin 32	02/14/2022

EHDD Job Number  
17050

Sheet Title

**FIRE ACCESS TO STREET**

Sheet Number

## G0.09

